

001-231-42

# WARREN PLACE

137'

Power Pole  $\rightarrow$  40.00'  $\rightarrow$  Guyed wire

### The East 40 Feet of Lot 42


r. Parking ~



Scale: 1"=20'

## SPOKANE STREET

### Plot 83-29 Lot 38A Block 65A

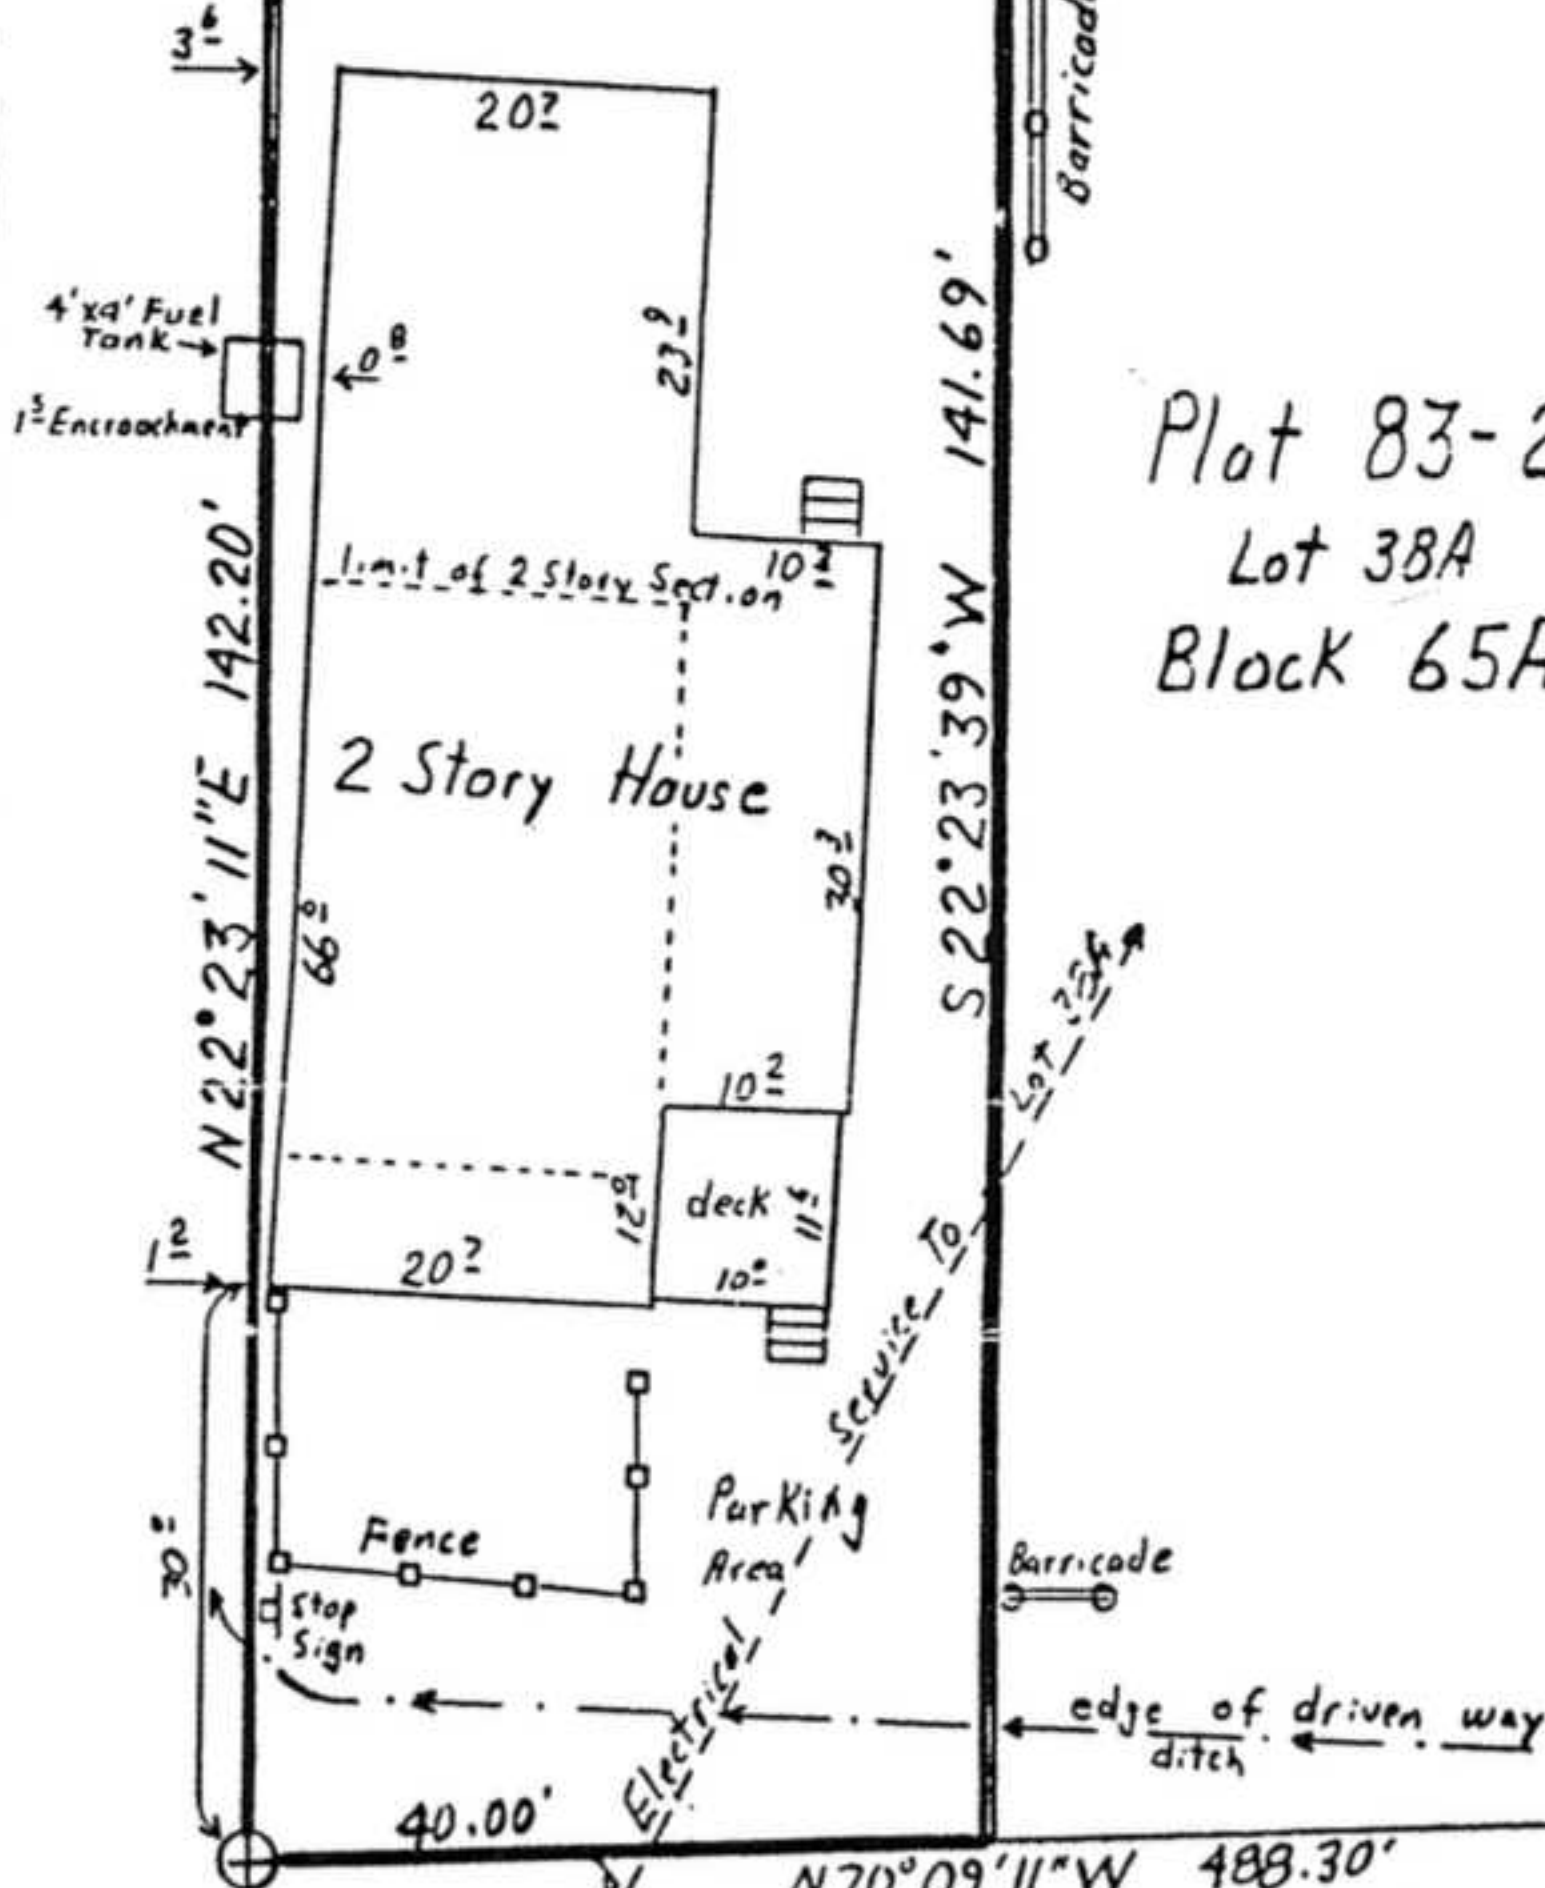

35'

Found 3" Brass Cap (Typical)

# KING PLACE

A SURVEY OF  
The East 40 Feet of Lot 40  
Block 65 of the Nome  
Townsite, US Survey No. 451

BY

GEORGE E. KRIER  
P.O. BOX 1058, NOME, AK 99762  
(907) 443-5358



1 August 1996