



**TENNESSEE DEPARTMENT OF ENVIRONMENT AND CONSERVATION  
DIVISION OF WATER RESOURCES  
CERTIFICATE OF COMPLETION OF A SUBSURFACE SEWAGE DISPOSAL SYSTEM**

**Issued to:** Samuel Goss

**Location:**

County: Cumberland

Address: 523 ferry bend trail

City: Crossville

Subdivision: Ferry Bend Trail

Lot #: 16

Map: 001 Group: \_\_\_\_\_ Parcel: 001.00

Installed by: Josh Lawson

Installer email: \_\_\_\_\_

Number of Bedrooms: 3

Gallons per Day: \_\_\_\_\_

Estimated Soil Absorption Rate: 30 MPI

- New Installation
- Repair Existing System
- System Modification
- Large System

- Type of System:**
- Conventional
  - Modified Conventional
  - Conventional System Substitute
  - Chamber
  - Poly Expanded Styrene
  - Large Diameter Gravelless Pipe
  - \_\_\_\_\_ Gravel backfill in a 24 in. trench required?
  - Low Pressure Pipe
  - Mound
  - Lagoon
  - Subsurface Drip Disposal
  - Other \_\_\_\_\_

Product: \_\_\_\_\_

Septic Tank Manufacture: Pug  
Volume (gal): 1,000

Effluent Pump? No  
Effluent Pump Manufacture: \_\_\_\_\_  
Effluent Pump Tank Volume: \_\_\_\_\_ gallons

Was the electric inspected? \_\_\_\_\_  
Electric Inspection Ticket #: \_\_\_\_\_  
Electric Inspection Date: \_\_\_\_\_

**Comments:**

**Please see attached site drawing and any other supporting documentation.**

Inspected by: Bryon Thompson  
DWR Staff

08/08/2025  
Date

Tennessee Department of Environment and Conservation - Division of Water Resources  
**Certificate of Completion of a Subsurface Sewage Disposal System**



Issued To: Samuel Goss  
 Location: 523 Ferry Bend Trail  
Crossville, Tn. 38571

Inspector: Bryon Thompson ESII  
 Date: 08/08/2025


General Notes:

- Please refer to the subsurface sewage disposal system details on the first page of the Certificate of Completion.
- Questions regarding the Certificate of Completion should be directed to the local Division of Water Resources representative.

The Subsurface Sewage Disposal System is Approved For:

(X) Residential: # of Bedrooms: 3  
 ( ) Other: \_\_\_\_\_  
 Gals/Day: \_\_\_\_\_

*B. Thompson ESII*

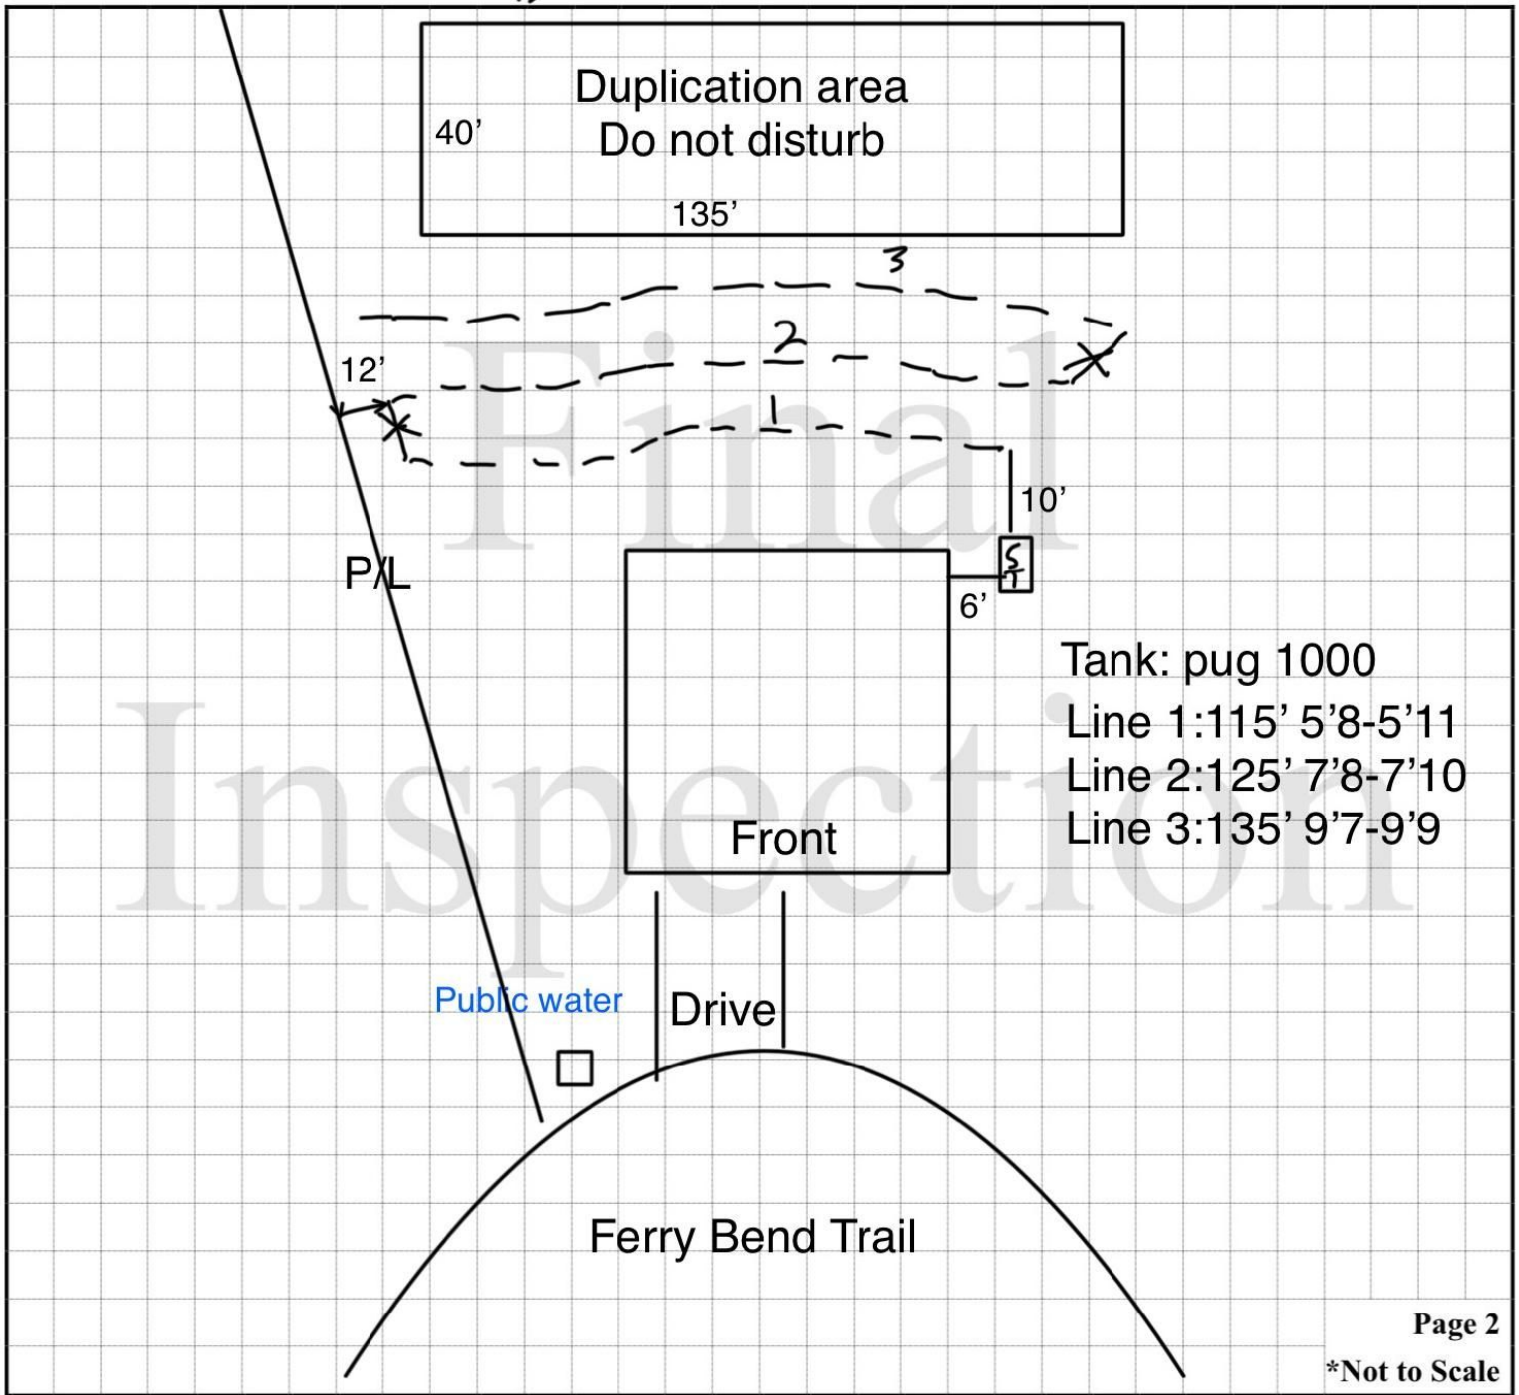

Tank: pug 1000  
 Line 1: 115' 5' 8"-5' 11"  
 Line 2: 125' 7' 8"-7' 10"  
 Line 3: 135' 9' 7"-9' 9"









