

**HIGHLAND COUNTY DEPARTMENT OF HEALTH**

YEAR 1993 TOWNSHIP Washington

NAME Marc Wilson

ADDRESS 652 N. High Street Hillsboro OH

PROPERTY LOCATION 9422 Ballentine  
Road Hillsboro OH 43110

DATE 12/16/93 INSTALLER Eric McCann

BEDROOMS 3 WATER County

SOIL TYPE Negly LOT SIZE 2.5 Ac.

**SEWAGE:**

SEPTIC TANK 15006 COMPARTMENTS 2

SECONDARY 460 feet Gravel

AERATION \_\_\_\_\_ G.P.D. \_\_\_\_\_ FILTER

MANUFACTURER Best Armbrust


OTHER \_\_\_\_\_

SANITARIAN Rob G. Garcia

**DIAGRAM OF SYSTEM**



S.R. 23

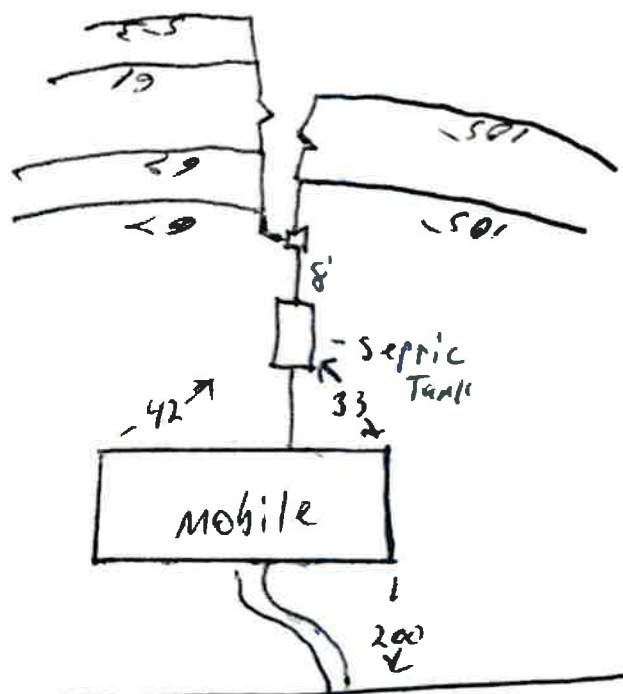

Ballentine Road