

HIGHLAND COUNTY DEPARTMENT OF HEALTH

YEAR 1993 TOWNSHIP Washington

NAME Marc Wilson

ADDRESS 652 N. High Street Hillsboro OH

PROPERTY LOCATION 9390 Ballentine Road Hillsboro OH 45133

DATE 12/20/93 INSTALLER Eric McCann

BEDROOMS 3 WATER County

SOIL TYPE Regly LOT SIZE 2.5 AC.

SEWAGE:

SEPTIC TANK 1500 COMPARTMENTS 2

SECONDARY 460 feet Gravel ~~System~~

Conventional Gravel System


AERATION _____ G.P.D. _____ FILTER

MANUFACTURER Best

OTHER _____

SANITARIAN Robt. G. Harris

DIAGRAM OF SYSTEM

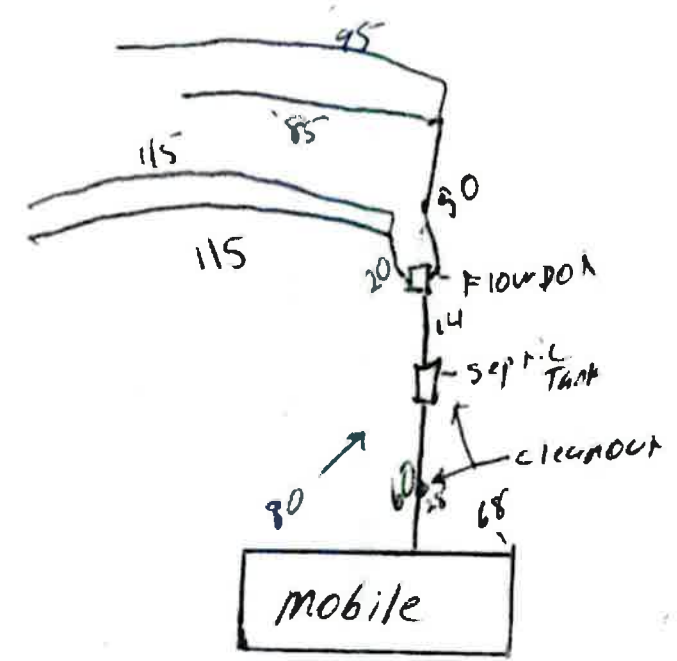

Ballentine Road