

Cherokee County Health Department

228 Hilton Street Murphy, NC 28906 (828) 835-3853

Permit #: 2024000346

Associated PDWW Permit: NA

SUBSURFACE SEWAGE SYSTEM OPERATIONS PERMIT

New Installation
 Addition to Existing System
 Repair
 Single family dwelling(s): #
 Multi-family dwelling
 Commercial (type):

Total Bedrooms: 2 Maximum # Occupants 4 Daily Flow: 240 gpd Zone: HD PIN#: 452300038053000

Property Owner/ Applicant: Kevin Klein

Property Description: Mountain View - Lot 11

Type of System: LDP-10 (Gravity) Saprofite: No System Class: III(f) Trench Depth: 20" Trench Width: 12"

Type of Repair: LDP-10 (Gravity) Saprofite: No System Class: III(f)

Septic Tank: 1000 gal Serial # NPC/STB-232 Pump Tank: Serial #

Drinking Source: Single Family Well Spring Shared Well/ Spring off-site Public Community


Date IP/CA issued: 8/23/24 Installer: Tripp Beaver Cert. # 1430

Operator Required? No Maintenance Inspection Required? No

Inspection Frequency: Health Dept.: NA Mgt. Entity: NA Reporting Frequency: NA

The following checked items are on file and are part of this Operations Permit. Application IP/CA Soil Sheet LSS Report Survey Engineer's Drawing

As-Built Diagram (Not to Scale)

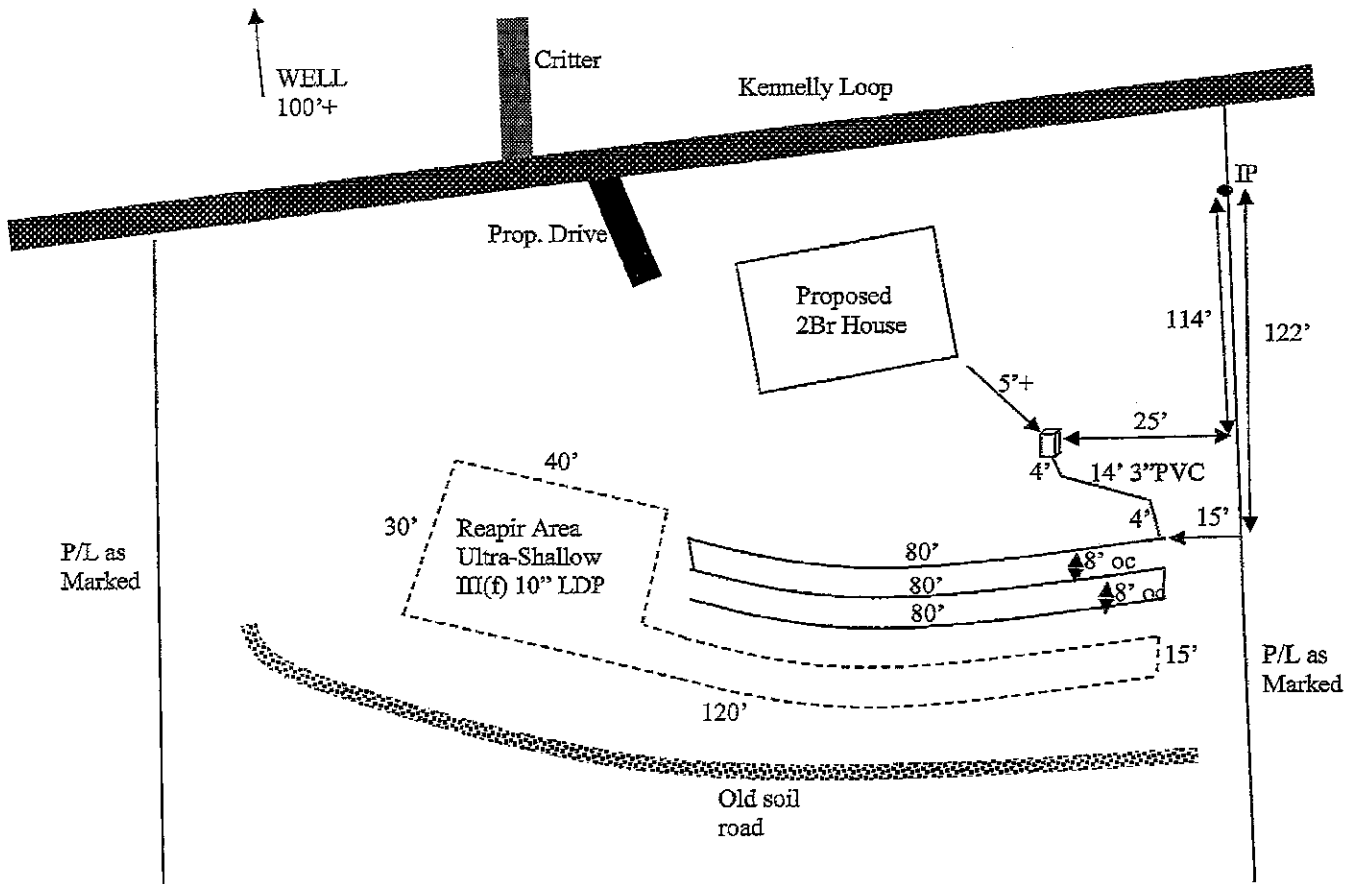

A representative of the Cherokee County Health Department has inspected this sewage disposal system and finds that it conforms to state guidelines. This Permit is issued subject to all the provisions of the North Carolina Laws and Rules for Sewage Treatment and Disposal. **No person is permitted to make alterations to this system without the approval of an authorized Environmental Health Specialist.** This approval indicates that this system has been installed in compliance with the standards as set forth in the above regulations, but shall in no way be taken as a guarantee that the system will function satisfactorily for any given period of time. The area designated as "repair area" is required for future use and must remain undisturbed.

Date of Issue: 9/13/2024

Jennifer K Wilson, REHS 2103

Jennifer K Wilson (Signature)

Authorized State Agent