FIELD WORK DATE: 11/22/2019

REVISION DATES: (REV.0 11/25/2019)

1911.4379
BOUNDARY SURVEY
POLK COUNTY

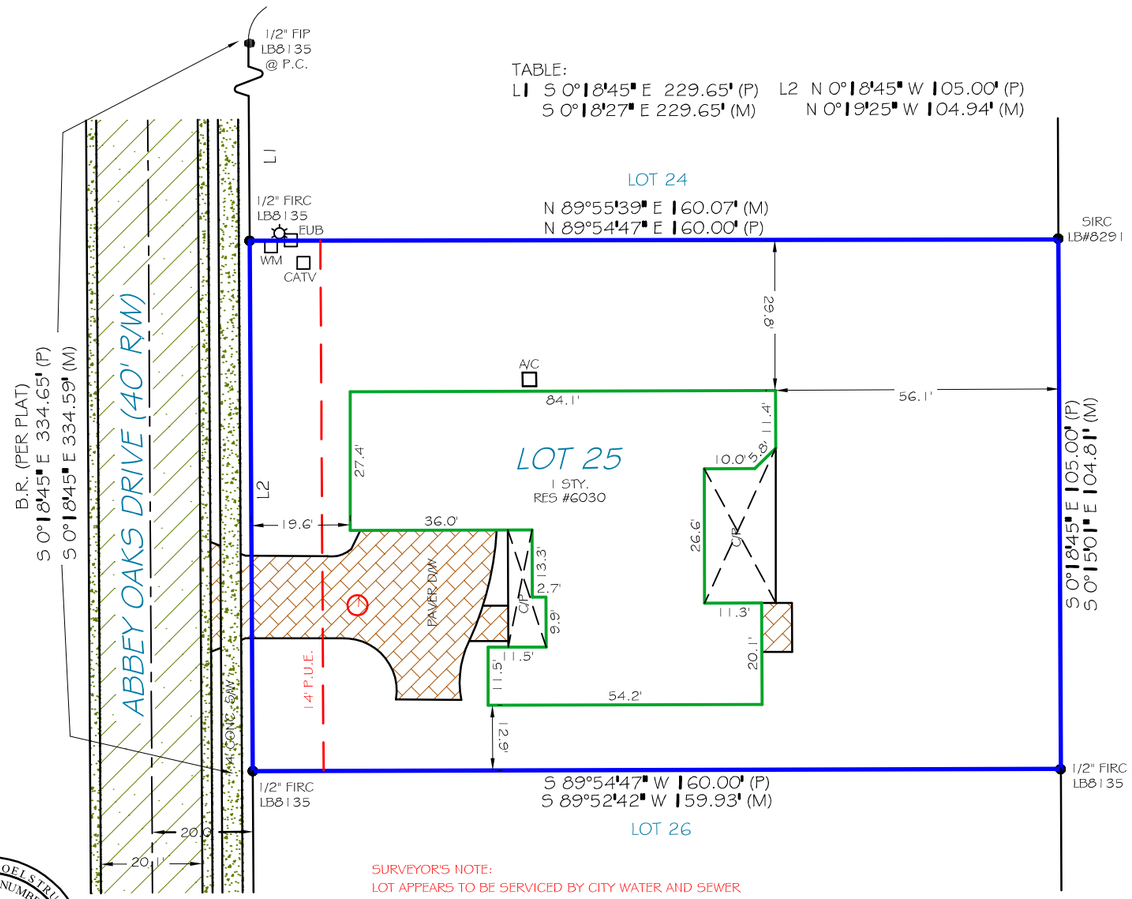

SURVEYOR'S NOTE:
LOT APPEARS TO BE SERVICED BY CITY WATER AND SEWER

TABLE:
L1 S 0°18'45" E 229.65' (P) S 0°18'27" E 229.65' (M)
L2 N 0°18'45" W 105.00' (P) N 0°19'25" W 104.94' (M)

JOHN F. TROELSTRUP LICENSE NUMBER 5946 STATE OF FLORIDA REGISTERED LAND SURVEYOR

John Troelstrup

I hereby certify that this Boundary Survey of the hereon described property has been made under my direction, and to the best of my knowledge and belief, it is a true and accurate representation of a survey that meets the Standards of Practice set forth by the Florida Board of Professional Surveyors & Mappers in Chapter 5J-17 of the Florida Administrative Code.

JOHN F. TROELSTRUP
State of Florida Professional Surveyor and Mapper
License No. 5946

30 0 15 30
GRAPHIC SCALE (In Feet)
1 inch = 30' ft.

N

Use of this survey other than intended, without written verification, will be at the users' sole risk and without liability to the surveyor.

The Sanoba Law Firm

PROPERTY ADDRESS	SURVEY NUMBER
6030 ABBEY OAKS DRIVE, LAKELAND, FLORIDA 33811	1911.4379

PROPERTY PICTURE

GOOGLE MAP

TRANSACTION

CLIENT ORDER NUMBER: 19-1526R **DATE:** 11/25/19

BUYER: Stephen L. Kerber and Debra E. Kerber

SELLER: HICKMAN HOMES, INC.

CERTIFIED TO:
STEPHEN L. KERBER AND DEBRA E. KERBER; THE SANOBA LAW FIRM; OLD REPUBLIC NATIONAL TITLE INSURANCE COMPANY; QUICKEN LOANS, INC.

LEGAL DESCRIPTION

LOT 25, ABBEY OAKS PHASE TWO, ACCORDING TO THE PLAT THEREOF, AS RECORDED IN PLAT BOOK 168, PAGE 3, OF THE PUBLIC RECORDS OF POLK COUNTY, FLORIDA.

POINTS OF INTEREST

1. PAVER DRIVEWAY OVER 14' PUBLIC UTILITY EASEMENT

FLOOD INFORMATION

BY PERFORMING A SEARCH WITH THE LOCAL GOVERNING MUNICIPALITY OR WWW.FEMA.GOV, THE PROPERTY APPEARS TO BE LOCATED IN ZONE X. THIS PROPERTY WAS FOUND IN POLK COUNTY, COMMUNITY NUMBER 120261, DATED 12/22/16.

JOB SPECIFIC SURVEYOR NOTES

THE BEARING REFERENCE OF SOUTH 0 DEGREES 18 MINUTES 45 SECONDS EAST IS BASED ON THE EASTERLY RIGHT-OF-WAY LINE OF ABBEY OAKS DRIVE, LOCATED WITHIN ABBEY OAKS PHASE TWO, ACCORDING TO THE PLAT THEREOF, AS RECORDED IN PLAT BOOK 168, PAGE 3, OF THE PUBLIC RECORDS OF POLK COUNTY, FLORIDA.

SURVEYOR'S LEGEND

(C)	CALCULATED
(D)	DEED
(F)	FIELD
(M)	MEASURED
(P)	PLAT
(R)	RECORD
(S)	SURVEY
A.S.B.L.	ACCESSORY SETBACK LINE
A/C	AIR CONDITIONING
B.C.	BLOCK CORNER
B.F.P.	BACKFLOW PREVENTOR
B.R.	BEARING REFERENCE
B.R.L.	BUILDING RESTRICTION LINE
B/W	BAY/BOX WINDOW
BLDG.	BUILDING
BLK.	BLOCK
BM	BENCHMARK
BSMT.	BASEMENT
C	CURVE
C.B.	CONCRETE BLOCK
C.L.F.	CHAIN LINK FENCE
C.O.	CLEAN OUT
C.V.G.	CONCRETE VALLEY GUTTER
C/L	CENTER LINE
C/P	COVERED PORCH
C/S	CONCRETE SLAB
CATV	CABLE TV RISER
CH	CHORD BEARING
CHIM.	CHIMNEY
CONC.	CONCRETE
COR.	CORNER
CS/W	CONCRETE SIDEWALK
D.F.	DRAIN FIELD
D.H.	DRILL HOLE
D/W	DRIVEWAY
E.O.W.	EDGE OF WATER
ELEV.	ELEVATION
EM	ELECTRIC METER
ENCL.	ENCLOSURE
ENT.	ENTRANCE
EUB	ELECTRIC UTILITY BOX
F.F.	FINISHED FLOOR
F.O.P.	EDGE OF PAVEMENT
F/DH	FOUND DRILL HOLE
FCM	FND. CONCRETE MONUMENT
FIP	FOUND IRON PIPE
FIPC	FOUND IRON PIPE & CAP
FIR.	FOUND IRON ROD
FIRC	FOUND IRON ROD & CAP
FN.	FOUND NAIL
FN&D	FOUND NAIL AND DISC
FND.	FOUND
FPKN	FOUND PARKER-KALON NAIL
FPKN&D	FOUND PK NAIL & DISC
FRRSPK	FOUND RAILROAD SPIKE
GAR.	GARAGE
GM	GAS METER
ID	IDENTIFICATION
ILL.	ILLEGIBLE
INST.	INSTRUMENT
INT.	INTERSECTION
L	LENGTH
LB#	LICENSE # - BUSINESS
LS#	LICENSE # - SURVEYOR
M.B.	MAP BOOK
M.E.S.	MITERED END SECTION
M.F.	METAL FENCE
MES	MITERED END SECTION
MH	MANHOLE
N.R.	NON RADIAL
N.T.S.	NOT TO SCALE
NAVD88	NORTH AMERICAN VERTICAL DATUM OF 1988
NGVD29	NATIONAL GEODETIC VERTICAL DATUM OF 1929
O.C.S.	ON CONCRETE SLAB
O.G.	ON GROUND
O.R.B	OFFICIAL RECORD BOOK
O.R.V.	OFFICIAL RECORD VOLUME
O/A	OVERALL
O/S	OFFSET
OFF	OUTSIDE OF SUBJECT PARCEL
OH.	OVERHANG
OHL	OVERHEAD LINES
ON	INSIDE OF SUBJECT PARCEL
P.B.	PLAT BOOK
P.C.	POINT OF CURVATURE
P.C.C.	POINT OF COMPOUND CURVATURE
P.C.P.	PERMANENT CONTROL POINT
P.I.	POINT OF INTERSECTION
P.O.B.	POINT OF BEGINNING
P.O.C.	POINT OF COMMENCEMENT
P/P	PINCHED PIPE
P.R.C.	POINT OF REVERSE CURVATURE
P.R.M.	PERMANENT REFERENCE MONUMENT
P.T.	POINT OF TANGENCY
P/E	POOL EQUIPMENT
PG.	PAGE
PLS	PROFESSIONAL LAND SURVEYOR
PLT.	PLANTER
PSM	PROFESSIONAL SURVEYOR AND MAPPER
R	RADIUS or RADIAL
R.P.	RADIUS POINT
R/W	RIGHT OF WAY
RES.	RESIDENCE
RGE.	RANGE
S.B.L.	SET BACK LINE
S.C.L.	SURVEY CLOSURE LINE
S.T.L.	SURVEY TIE LINE
S.W.	SEAWALL
S/GD	SET GLUE DISC
S/W	SIDEWALK
SCR.	SCREEN
SEC.	SECTION
SEP.	SEPTIC TANK
SEW.	SEWER
SIRC.	SET IRON ROD & CAP
SN&D	SET NAIL & DISC
SQ.FT.	SQUARE FEET
STY.	STORY
SV	SEWER VALVE
T.O.B.	TOP OF BANK
TBM	TEMPORARY BENCHMARK
TEL.	TELEPHONE FACILITIES
TWP.	TOWNSHIP
TX	TRANSFORMER
TYP.	TYPICAL
U.R.	UTILITY RISER
UG	UNDERGROUND
UR	UTILITY RISER
V.F.	VINYL FENCE
W.F.	WOODEN FENCE
W/C	WITNESS CORNER
W/F	WATER FILTER
WM	WATER METER/VALVE BOX
WV	WATER VALVE
A.E.	ACCESS EASEMENT
AN.E.	ANCHOR EASEMENT
C.M.E.	CANAL MAINTENANCE ESMT.
C.U.E.	COUNTY UTILITY ESMT.
D.E.	DRAINAGE EASEMENT
D.U.E.	DRAINAGE AND UTILITY ESMT.
ESMT.	EASEMENT
I.E.&.R.E.	INGRESS/EGRESS ESMT.
IRR.E.	IRRIGATION EASEMENT
L.A.E.	LIMITED ACCESS ESMT.
L.B.E.	LANDSCAPE BUFFER ESMT.
L.E.	LANDSCAPE ESMT.
L.M.E.	LAKE OR LANDSCAPE MAINTENANCE EASEMENT
M.E.	MAINTENANCE EASEMENT
P.U.E.	PUBLIC UTILITY EASEMENT
R.O.E.	ROOF OVERHANG ESMT.
S.W.E.	SIDEWALK EASEMENT
S.W.M.E.	STORM WATER MANAGEMENT EASEMENT
T.U.E.	TECHNOLOGICAL UTILITY ESMT.
U.E.	UTILITY EASEMENT

THANKS TO

Florida Land Title Association — AFFILIATE MEMBERS

GENERAL SURVEYOR NOTES

1. The Legal Description used to perform this survey was supplied by others. This survey does not determine or imply ownership.
2. This survey only shows improvements found above ground. Underground footings, utilities and encroachments are not located on this survey map.
3. If there is a septic tank, or drain field shown on this survey, the location is approximate as the location was either shown to Exacta Land Surveyors, LLC. by a third party or it was estimated by metal detection, probing rods, and visual above ground inspection only. No excavation was performed in order to determine the exact and accurate location.
4. This survey is exclusively for the use of the parties to whom it is certified.
5. Additions or deletions to this survey map and report by other than the signing party or parties is prohibited without written consent of the signing party or parties.
6. Dimensions are in feet and decimals thereof.
7. Due to varying construction standards, house dimensions are approximate.
8. Any FEMA flood zone data contained on this survey is for informational purposes only. Research to obtain such data was performed at www.fema.gov.
9. All corners marked as set are at a minimum a ½"diameter, 18" iron rebar with a cap stamped LB# 8291.
10. If you are reading this survey in an electronic format, the information contained on this document is only valid if this document is electronically signed as specified in Chapter 5J-17.062 (3) of the Florida Administrative Code and Florida Statute 472.025. The Electronic Signature File related to this document is prominently displayed on the invoice for this survey which is sent under separate cover. Manually signed and sealed logs of all survey signature files are kept in the office of the performing surveyor. If this document is in paper format, it is not valid without the signature and original raised seal of a Florida Licensed Surveyor.
11. Unless otherwise noted, an examination of the abstract of title was NOT performed by the signing surveyor to determine which instruments, if any, are affecting this property.
12. The symbols reflected in the legend and on this survey may have been enlarged or reduced for clarity. The symbols have been plotted at the center of the field location, and may not represent the actual shape or size of the feature.
13. Points of Interest (POI's) are selected above-ground improvements which may be in conflict with boundary, building setback or easement lines, as defined by the parameters of this survey. There may be additional POI's which are not shown, not called-out as POI's, or which are otherwise unknown to the surveyor. These POI's may not represent all items of interest to the viewer.
14. Utilities shown on the subject property may or may not indicate the existence of recorded or unrecorded utility easements.
15. The information contained on this survey has been performed exclusively, and is the sole responsibility, of Exacta Land Surveyors, LLC.. Additional logo or references to third party firms are for informational purposes only.
16. Pursuant to F.S. 558.0035, an individual employee or agent may not be held individually liable for negligence.
17. House measurements should not be used for new construction or planning. Measurements should be verified prior to such activity.

PERFORMED BY

EXACTA
LAND SURVEYORS, LLC.
LB# 8291 | 11940 Fairway Lakes Drive | Suite 1 | Fort Myers, FL 33913
P: 866.735.1916 | F: 866.744.2882